

ADDENDUM #1

FRANKLIN STREET DRAINAGE STRUCTURE REPLACEMENT

ADDENDUM #1
2 MARCH 2017
NUMBER OF PAGES: 1

NOTICE:

This addendum is issued to modify, explain or correct the original drawings, specifications and/or previous addenda and is hereby made part of the Contract Documents. **Please attach this Addendum to the specifications in your possession and note receipt of the Addendum on the first page of your bid.**

1. **DRAWING S2.3 NOTE 6 - indicates the steel beams and column brackets are to be removed and remain the property of the contractor. ADD: This includes the timber stringers.**
2. **ADD – Drawing 'Drainage Structure Temporary Shoring' (attached below). Shoring installed in 2016. To be used as additional information to help determine maximum load limits of the installed system.**

End of Addendum

ABBREVIATIONS

Z	ANGLE	D	DEGREE OF CURVE	HD	HEAD	N	NORTH	S	SOUTH	VAR	VARIES
Δ	CENTRAL ANGLE	DEFL	DEFLECTION	H.E.F.	HORIZONTAL EACH FACE	N/A	NOT APPLICABLE, NOT AVAILABLE	S=	SUPERELEVATION	VC	VERTICAL CURVE
AB	ANCHOR BOLT	DIA (ø)	DIAMETER	H.I.F.	HORIZONTAL INSIDE FACE	NE'LY	NORTHEASTERLY	SAN	SANITARY	VCP	VITRIFIED CLAY PIPE
A/C	AIR CONDITIONING(ER)	DIAG	DIAGONAL	HK	HOOK	N.F.	NEAR FACE	SANS	SANITARY SEWER	V.E.F.	VERTICAL EACH FACE
AC	ACRES	DIM	DIMENSION	H.M.	HOLLOW METAL	N'LY	NORTHERLY	SB	SOIL BORING	VER	VERIFY
AD	ALGEBRAIC DIFFERENCE	DIP	DUCTILE IRON PIPE	HMA	HOT MIX ASPHALT	NO/#	NUMBER	SCH	SCHEDULE	VERT	VERTICAL
ADD'L	ADDITIONAL	DIST	DISTANCE	H.O.F.	HORIZONTAL OUTSIDE FACE	N.S.	NEAR SIDE	SD	SUB DRAIN	V.I.F.	VERTICAL INSIDE FACE
A.F.F.	ABOVE FINISHED FLOOR	DL	DEAD LOAD	HORIZ	HORIZONTAL	NIC	NOT IN CONTRACT	SDL	SUPERIMPOSED DEAD LOAD	V.O.F.	VERTICAL OUTSIDE FACE
AGG	AGGREGATE	DN	DOWN	HP	HORSEPOWER	NOM	NOMINAL	SEC	SECTION	VOL	VOLUME
ALT	ALTERNATING	DRWY	DRIVEWAY	HPT	HIGH POINT	NTS	NOT TO SCALE	SE'LY	SOUTHEASTERLY	VPC	VERTICAL POINT OF CURVE
ALUM	ALUMINUM	DS	DOWNSPOUT	H.S.A.	HEADED STUD ANCHOR	NW'LY	NORTHWESTERLY	SF	SQUARE FOOT	VPI	VERTICAL POINT OF INTERSECTION
ANCH	ANCHOR	DWG(S)	DRAWING(S)	H.S.S.	HOLLOW STRUCTURAL SECTION			S.F.	SPLIT FACE	VPT	VERTICAL POINT OF TANGENCY
AOH	ARROW ON HYDRANT	DWL(S)	DOWEL(S)	HT	HEIGHT	OC	ON CENTER	S.F.D.	STEP FOOTING DOWN		
ARCH	ARCHITECTURAL			HYD	HYDRANT	OD	OUTSIDE DIAMETER	SHT	SHEET	W	WEST
ASPH	ASPHALT	E	EAST	ID	INSIDE DIAMETER/INSIDE DIMENSION	O.F.	OUTSIDE FACE	SIG.	SIGNAL	W/	WITH
AVG	AVERAGE	E'LY	EASTERLY	IE	INVERT ELEVATION	O.H.	OVER HEAD	SIM.	SIMILAR	W'LY	WESTERLY
		EA	EACH	I.F.	INSIDE FACE	OP'G	OPENING	S'LY	SOUTHERLY	WM	WATER MAIN
B-B	BACK OF CURB TO BACK OF CURB	E.E.	EACH END	I.J.	ISOLATION JOINT	OPP	OPPOSITE	SLL	SUPERIMPOSED LIVE LOAD	W/O	WITHOUT
B.B.	BOND BEAM	E.F.	EACH FACE	IMP	IMPROVEMENTS	PC	POINT OF CURVE	SOG	SLAB ON GRADE	W.P.	WORKING POINT
B/C	BACK OF CURB	EFF	EFFECTIVE	IN	INCHES	P.C.	PRECAST/PRESTRESSED CONCRETE	SPC	SPACE	WD	WOOD
BD	BOARD	EJ	EXPANSION JOINT	INFO	INFORMATION	P.C.F	POUNDS PER CUBIC FOOT	SPEC	SPECIFICATION	WND	WINDOW
B/Ditch	BOTTOM OF DITCH	EL	ELEVATION	INSP	INSPECTION	PCF	POUNDS PER CUBIC FOOT	SQ	SQUARE	WSO	WATER SHUT OFF
BFP	BACKFLOW PREVENTOR	ELEC	ELECTRICAL	INST	INSTALLATION	PCC	PORTLAND CEMENT CONCRETE	SS	STAINLESS STEEL	WT	WEIGHT
B/L	BASE LINE	ELEV	ELEVATOR	INSUL	INSULATION	PE	PEDESTAL/PEDESTRIAN	ST	STREET	WV	WATER VALVE
B.L.	BRICK LEDGE	EMBED	EMBEDMENT	INT	INTERIOR	PERF	PERFORATED	STA	STATION	WWF	WELDED WIRE FABRIC
B/S	BOTTOM OF SLOPE	ENGR	ENGINEER	INTR	INTERSECTION	PERIM	PERIMETER	STAG	STAGGERED		
BLDG	BUILDING	ENTR	ENTRANCE	INVT	INVERT	PERP	PERPENDICULAR	STD	STANDARD	X	CROSS
BLK	BLOCK	EOP	END OF PROJECT	IP	IRON PIPE	PI	POINT OF INTERSECTION	STIFF	STIFFENER	XSTG	EXTRA STRONG
BLKG	BLOCKING	EOR	END OF RADIUS	JB	JUNCTION BOX	P/L	PROPERTY LINE	STL	STEEL	XXSTG	DOUBLE EXTRA STRONG
BNT	BENT	E/P	EDGE OF PAVEMENT	JT	JOINT/JOINT LENGTH	PL	PLATE	STM	STORM		
BM	BEAM	EQ	EQUAL	JST(S)	JOIST(S)	PLF	POUNDS PER LINEAL FOOT	STMS	STORM SEWER	YD	YARD
B.M.	BENCH MARK	E/S	EDGE OF SHOULDER	K	RATE OF VERTICAL CURVATURE	PLK	PLANK	STR	STRUCTURE/STRUCTURAL		
BOP	BEGINNING OF PROJECT	ESMT	EASEMENT	K	RATE OF VERTICAL CURVATURE	PM	PRINCIPAL MERIDIAN	SUPP	SUPPORT		
BOT	BOTTOM	EST	ESTIMATE	K	RATE OF VERTICAL CURVATURE	POB	POINT OF BEGINNING	SW'LY	SOUTHWESTERLY		
BRG	BEARING	EX	EXISTING	K	RATE OF VERTICAL CURVATURE	POC	POINT OF CURVE	SY	SQUARE YARD		
BRKT	BRACKET	EXC	EXCAVATE/EXCAVATION	K	RATE OF VERTICAL CURVATURE	POT	POINT OF TANGENT	SYM	SYMBOL		
BSTM	BASEMENT	EXP	EXPANSION	K/FT	KIPS PER FOOT	PRC	POINT OF REVERSE CURVE	SYMM	SYMMETRICAL		
BTWN	BETWEEN	EXT	EXTENSION	KIP	1 KIP = 1,000 LBS	PRELIM	PRELIMINARY				
BV	BUTTERFLY VALVE	EXTD	EXTEND	KSF	KIPS PER SQUARE FOOT	PROJ	PROJECTION	T	TANGENT LENGTH		
		EW	EACH WAY	L	LENGTH OF CURVE	PROP	PROPOSED	T/B	TOP OF BANK		
C&G	CURB AND GUTTER	FD	FLOOR DRAIN	LAT	LATERAL	PRV	PRESSURE REDUCING VALVE	T/DITCH	TOP OF DITCH		
CANT	CANTILEVER	FDN	FOUNDATION	LB/#	POUND	PS	PRESTRESSED CONCRETE	T/C	TOP OF CURB		
CATV	CABLE TELEVISION	FE	FIRE EXTINGUISHER	LF	LINEAL FOOT	PSF	POUNDS PER SQUARE FOOT	T/GRAV	TOP OF GRAVEL		
CB	CATCH BASIN	F.E.	FIELD ENTRANCE	LL	LIVE LOAD	PSI	POUNDS PER SQUARE INCH	T/WALL	TOP OF WALL		
C-C	CENTER TO CENTER	FES	FLARED END SECTION	LLH	LONG LEG HORIZONTAL	P.T.	PAINTED	T/P	TOP OF PAVEMENT		
CF	CUBIC FEET	F-F	FACE TO FACE	LLV	LONG LEG VERTICAL	PT	POINT OF TANGENCY	T/S	TOP OF SLOPE		
CH	CHORD	F&I	FURNISH & INSTALL	LONG	LONGITUDINAL	PVC	POLYVINYL CHLORIDE	T/SUB	TOP OF SUBGRADE		
CH BRG	CHORD BEARING	F.F.	FAR FACE	LP	LIGHT POLE	PVMT	PAVEMENT	T/W	TOP OF WALK		
CIP	CAST IRON PIPE	FFE	FINISH FLOOR ELEVATION	LPT	LOW POINT	QTY	QUANTITY	T & B	TOP AND BOTTOM		
C-I-P	CAST-IN-PLACE	FG	FORM GRADE	LT	LEFT	R	RADIUS	T.O.B.	TOP OF BEAM		
CISP	CAST IRON SOIL PIPE	FIN GR	FINISHED GRADE	LTL	LINTEL	R.D.	ROOF DRAIN	T.O.B.L.	TOP OF BRICK LEDGE		
CJ	CONTROL JOINT	FL	FLOWLINE	LW	LIGHT WEIGHT	R&R	REMOVE & REPLACE	T.O.C.	TOP OF CONCRETE		
CL	CENTERLINE	FLG	FLANGE	MAS	MASONRY	R&S	REMOVE & SALVAGE	T.O.E.F.	TOP OF EXISTING FOOTING		
CLG	CEILING	FLR	FLOOR	MAX	MAXIMUM	RCB	REINFORCED CONCRETE BOX	T.O.F.	TOP OF FOOTING		
CLR	CLEAR	FND	FOUNDATION	MBR	MEMBER	RCP	REINFORCED CONCRETE PIPE	T.O.M.	TOP OF MASONRY		
CLR	CLEAR	FRM	FRAME	ME	MATCH EXISTING	RD	ROAD	T.O.P.	TOP OF PIER		
CMP	CORRUGATED METAL PIPE	F.S.	FAR SIDE	MECH	MECHANICAL	REBAR	REINFORCING BAR	T.O.S.	TOP OF STEEL		
CMU	CONCRETE MASONRY UNIT	FT	FOOT/FEET	MEZZ	MEZZANINE	REF	REFERENCE	TCE	TEMPORARY CONSTRUCTION EASEMENT		
CO	CLEAN OUT	FTG	FOOTING	MFR	MANUFACTURER	REIN	REINFORCING/REINFORCED	TEL	TELEPHONE		
COL	COLUMN	FUT	FUTURE	MH	MANHOLE	REM	REMAINDER	TEMP	TEMPORARY		
COMP	COMPACTED	FV	FIELD VERIFY	MIN	MINIMUM	REQ	REQUIRED	TERM	TERMINATE		
CONC	CONCRETE	G	GUTTER	MISC	MISCELLANEOUS	REV	REVISION	TGB	TOP OF GRADE BEAM		
COND	CONDITION	GA	GAGE	ML	MICRO LAMINATED WOOD	RIM	RIM ELEVATION	THD	THREAD		
CONN	CONNECTION	GC	GENERAL CONTRACTOR	MO	MOISTURE RESISTANT	R.O.	ROUGH OPENING	THK	THICK / THICKNESS		
CONST	CONSTRUCTION	GALV	GALVANIZED	MOD	MODIFY	ROW	RIGHT OF WAY	TPD	TEMPERED		
CONT	CONTINUOUS	GL	GLUE LAMINATED WOOD	MON	MONUMENT	RP	RADIUS POINT	TPG	TOPPING		
CONTR	CONTRACTOR	GND	GROUND	MTD	MOUNTED	RR	RAILROAD	TRANS	TRANSVERSE		
COORD	COORDINATE	GRN	GRANULAR			RS	RESILIENT SEAT	TS	TUBE STEEL		
COR	CORNER	GRD	GRADE			RT	RIGHT	TWP	TOWNSHIP		
CP	CONTROL POINT	GV	GATE VALVE					TYP	TYPICAL		
CPE	CORRUGATED POLYETHYLENE PIPE	GYP	GYP SUM					U	UTILITY		
CRST	CRUSHED STONE							UAC	USE AS CONSTRUCTED		
CSP	CORRUGATED STEEL PIPE							UE	UTILITY EASEMENT		
CTRD	CENTERED							UL	UNDERWRITERS LABRATORIES, INC.		
CTR	CENTER							ULFM	UNDERWRITERS LABRATORIES FACTORY MUTUAL		
CU	CUBIC							UNO	UNLESS NOTED OTHERWISE		
CULT	CULTIVATED										
CV	CHECK VALVE										
CY	CUBIC YARD										



© COPYRIGHT 2016
ALL RIGHTS RESERVED.
THESE DOCUMENTS HAVE BEEN
PREPARED SPECIFICALLY FOR THIS
PROJECT ONLY. NO PART OF THIS
DOCUMENT MAY BE REPRODUCED
OR DISTRIBUTED IN ANY FORM
WITHOUT THE PERMISSION OF IIW,
P.C. ALL INFORMATION IN THIS
DOCUMENT IS CONSIDERED
PROPERTY OF IIW, P.C.



Project Description

ABBREVIATIONS


SHEET TITLE 3
FRANKLIN STREET
DRAINAGE STRUCTURE TEMPORARY SHORING
GALENA, ILLINOIS

P:\16178\DRAWINGS\CIVIL\16178_ZZ_COVER.DWG 9/7/2016 1:03 PM DAVE SCHWARTZ

Rev	Description	Date	By

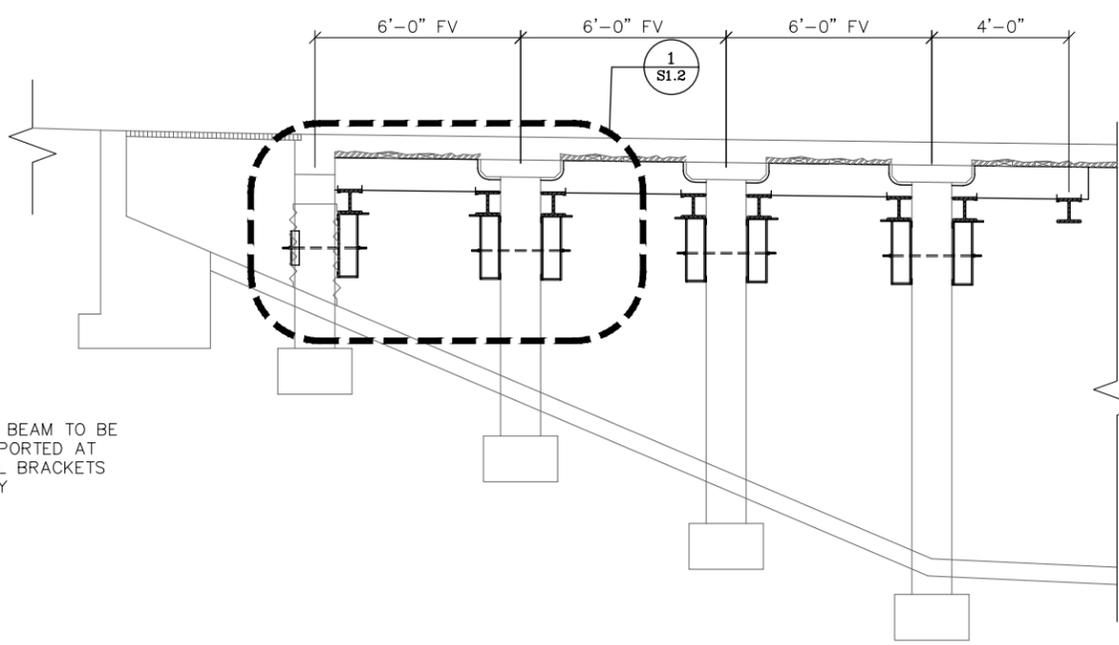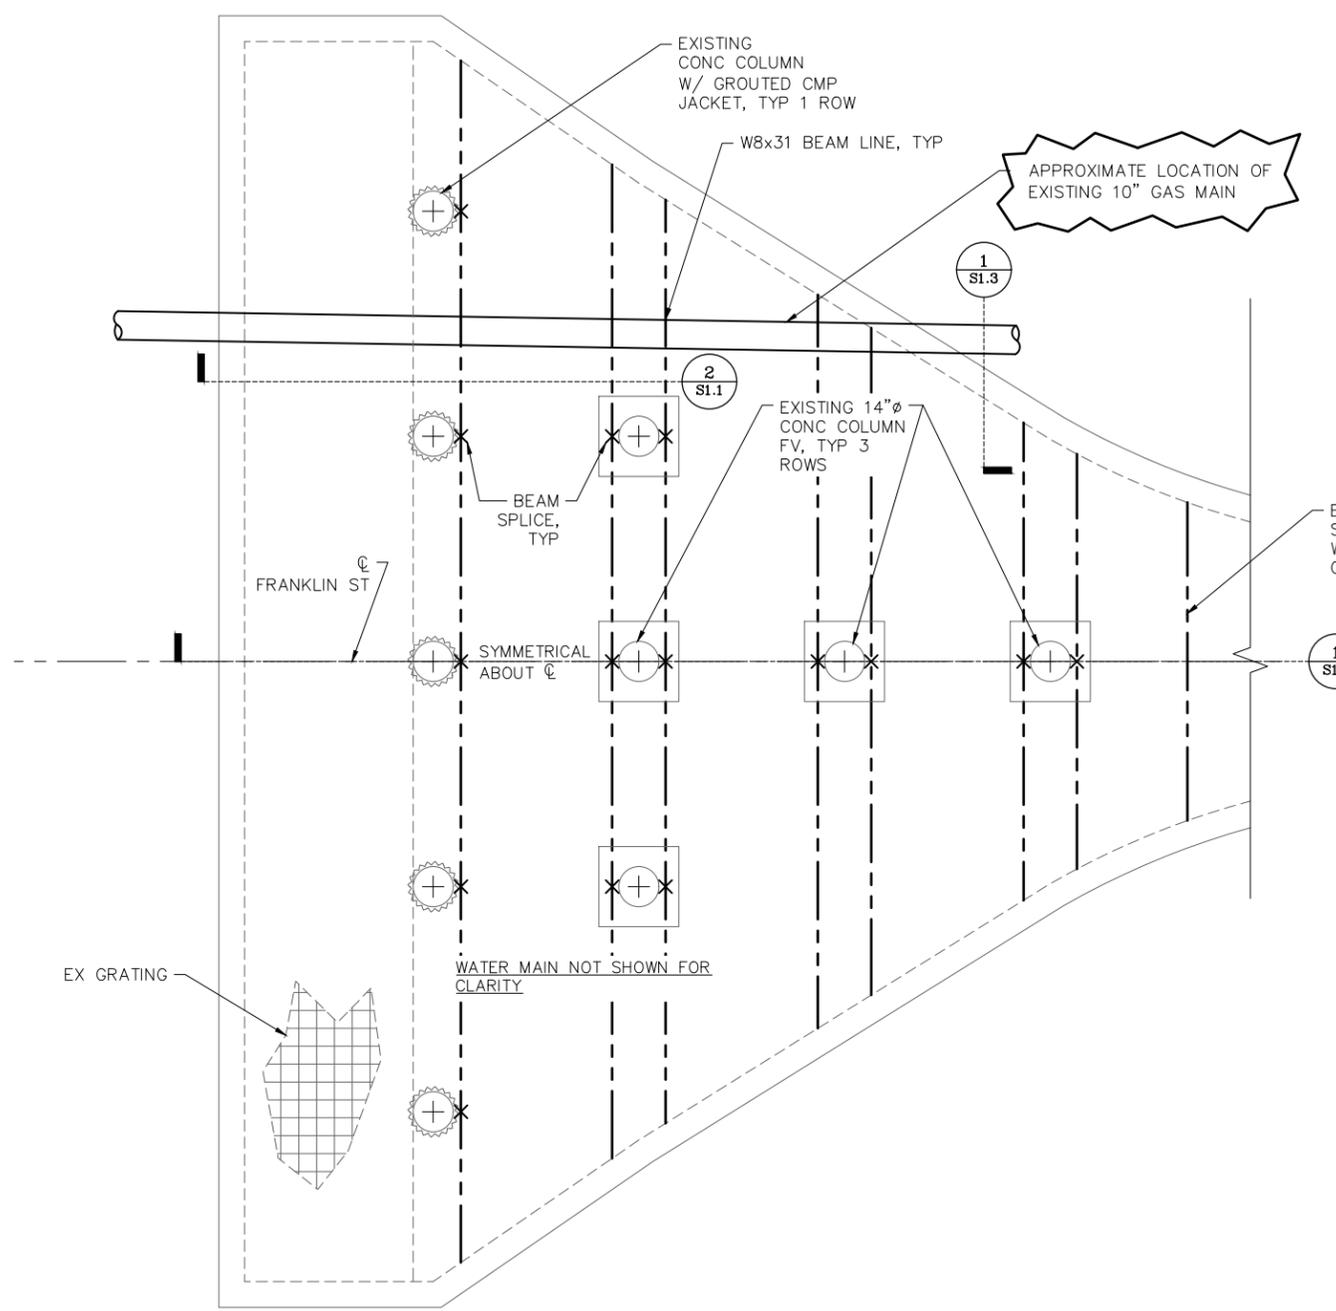

1 SECTION @ COLUMNS
 11x17 SCALE: 3/16" = 1'-0"
 22x34 SCALE: 3/8" = 1'-0"

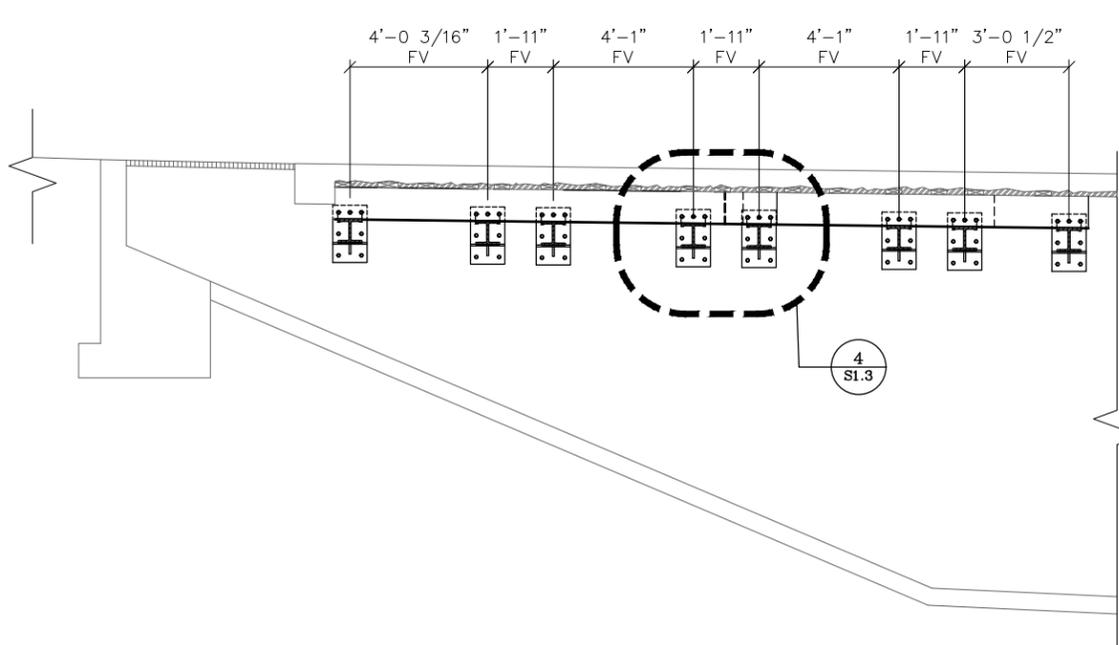


2 SECTION @ ENDS
 11x17 SCALE: 3/16" = 1'-0"
 22x34 SCALE: 3/8" = 1'-0"

STEEL BEAM FRAMING PLAN
 11x17 SCALE: 3/16" = 1'-0"
 22x34 SCALE: 3/8" = 1'-0"

BEAM SPLICING NOTES:
 X - INDICATES OPTIONAL BEAM SPLICE LOCATIONS
 ALL SPLICES MUST BE CENTERED ON COLUMNS.
 SITE ACCESS LIMITS BEAMS TO A MAXIMUM LENGTH OF 12' TO 15'.
 SEE SHEET S1.3 FOR SPLICE DETAILS.



Rev	Date	By	Description

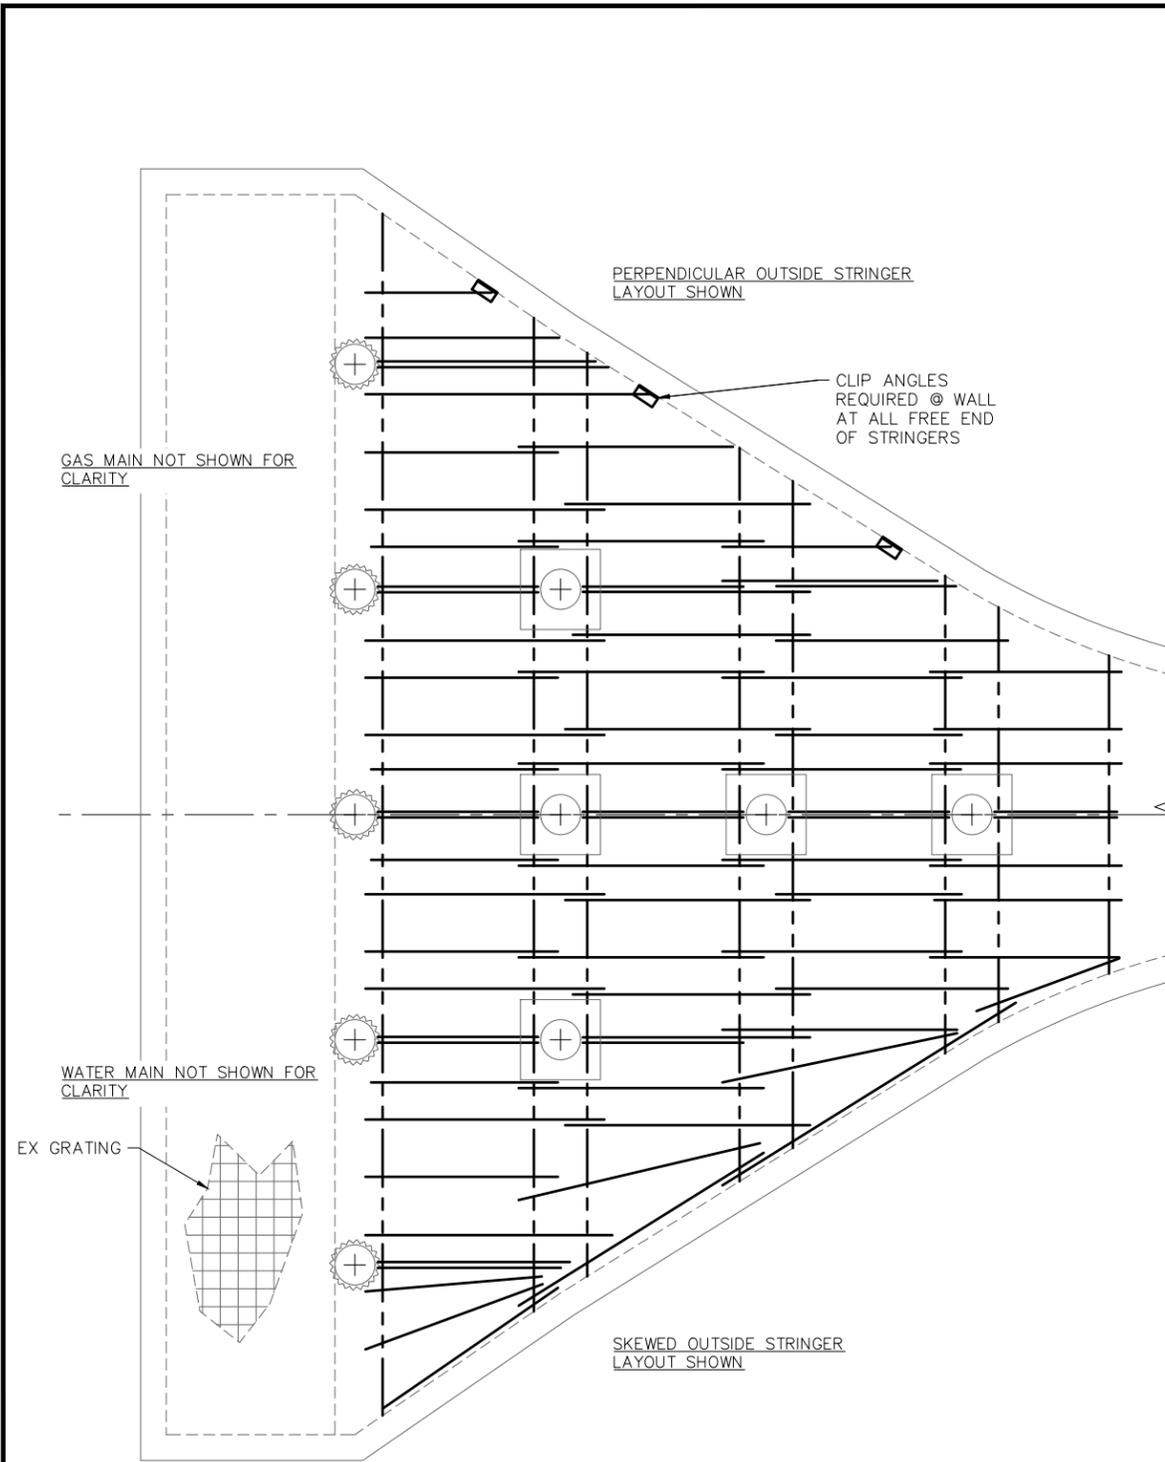


TIMBER STRINGER FRAMING PLAN

11x17 SCALE: 3/16" = 1'-0"
22x34 SCALE: 3/8" = 1'-0"

- TIMBER STRINGER NOTES:**
1. STRINGER LAYOUT SHOWN FOR 3X10 STRINGERS @ 2'-0" NOMINAL SPACING. STRINGERS MAY BE CONSTRUCTED USING PROPERLY FASTENED (2) PLY 2X10 DIMENSIONAL LUMBER.
 2. TIMBER STRINGERS MAY BE LAP SPLICED OVER ANY BEAM LINE. EVERY OTHER STRINGER SHALL BE CONTINUOUS ACROSS ADJACENT BEAMS ON THE SAME COLUMN.
 3. SET STRINGER LINES ON EITHER SIDE OF ALL COLUMN CAPITALS.
 4. SET DOUBLED COPED STRINGER LINE AT CENTERLINE OF EACH COLUMN LINE.
 5. OUTSIDE LINE OF STRINGERS MAY RUN PERPENDICULAR TO BEAM LINES AND TERMINATE WITH CLIP ANGLES OR ANCHORS TO STRUCTURE WALLS, OR
OUTSIDE STRINGERS MAY BE SKEWED TO ACCOMMODATE WALL FLARE. SKEWED STRINGERS MUST NOT EXCEED NOMINAL SPACING SHOWN.

ALTERNATE STRINGER MATERIALS AND LAYOUTS TO BE APPROVED BY THE ENGINEER:
1. W8x31 @ 3'-0 NOM.

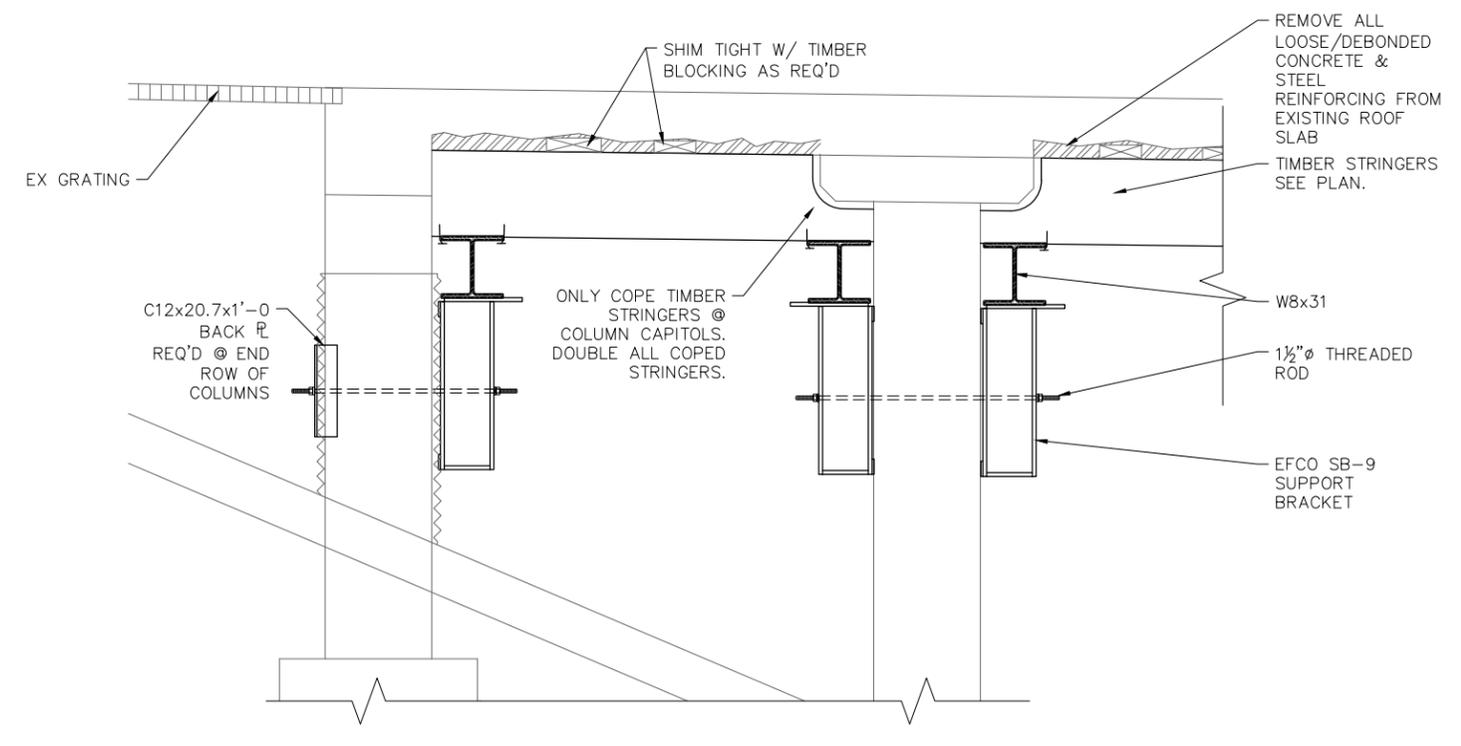

1 **DETAIL @ COLUMNS**
S1.2



11x17 SCALE: 1/2" = 1'-0"
22x34 SCALE: 1" = 1'-0"

© COPYRIGHT 2014
ALL RIGHTS RESERVED.
THESE DOCUMENTS HAVE BEEN
PREPARED SPECIFICALLY FOR THIS
PROJECT ONLY. NO PART OF THIS
DOCUMENT MAY BE REPRODUCED
OR DISTRIBUTED IN ANY FORM
WITHOUT THE PERMISSION OF IIW,
P.C. ALL INFORMATION IN THIS
DOCUMENT IS CONSIDERED
PROPERTY OF IIW, P.C.

DETAILS
FRANKLIN STREET
DRAINAGE STRUCTURE TEMPORARY SHORING
GALENA, ILLINOIS
P. 16\178 DRAWINGS\STRUCTURAL\16178_STR_SHEETS\DATE.DWG 9/7/2016 1:03 PM DAVE SCHWARZ

Rev	Date	By	Description

Project Description	Date	By

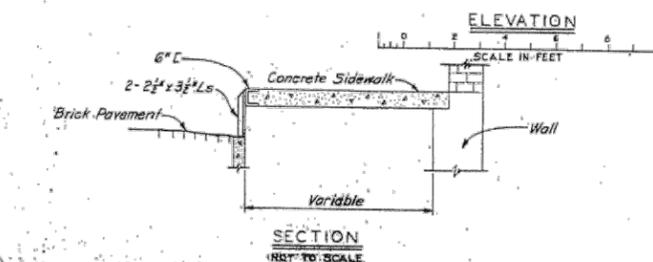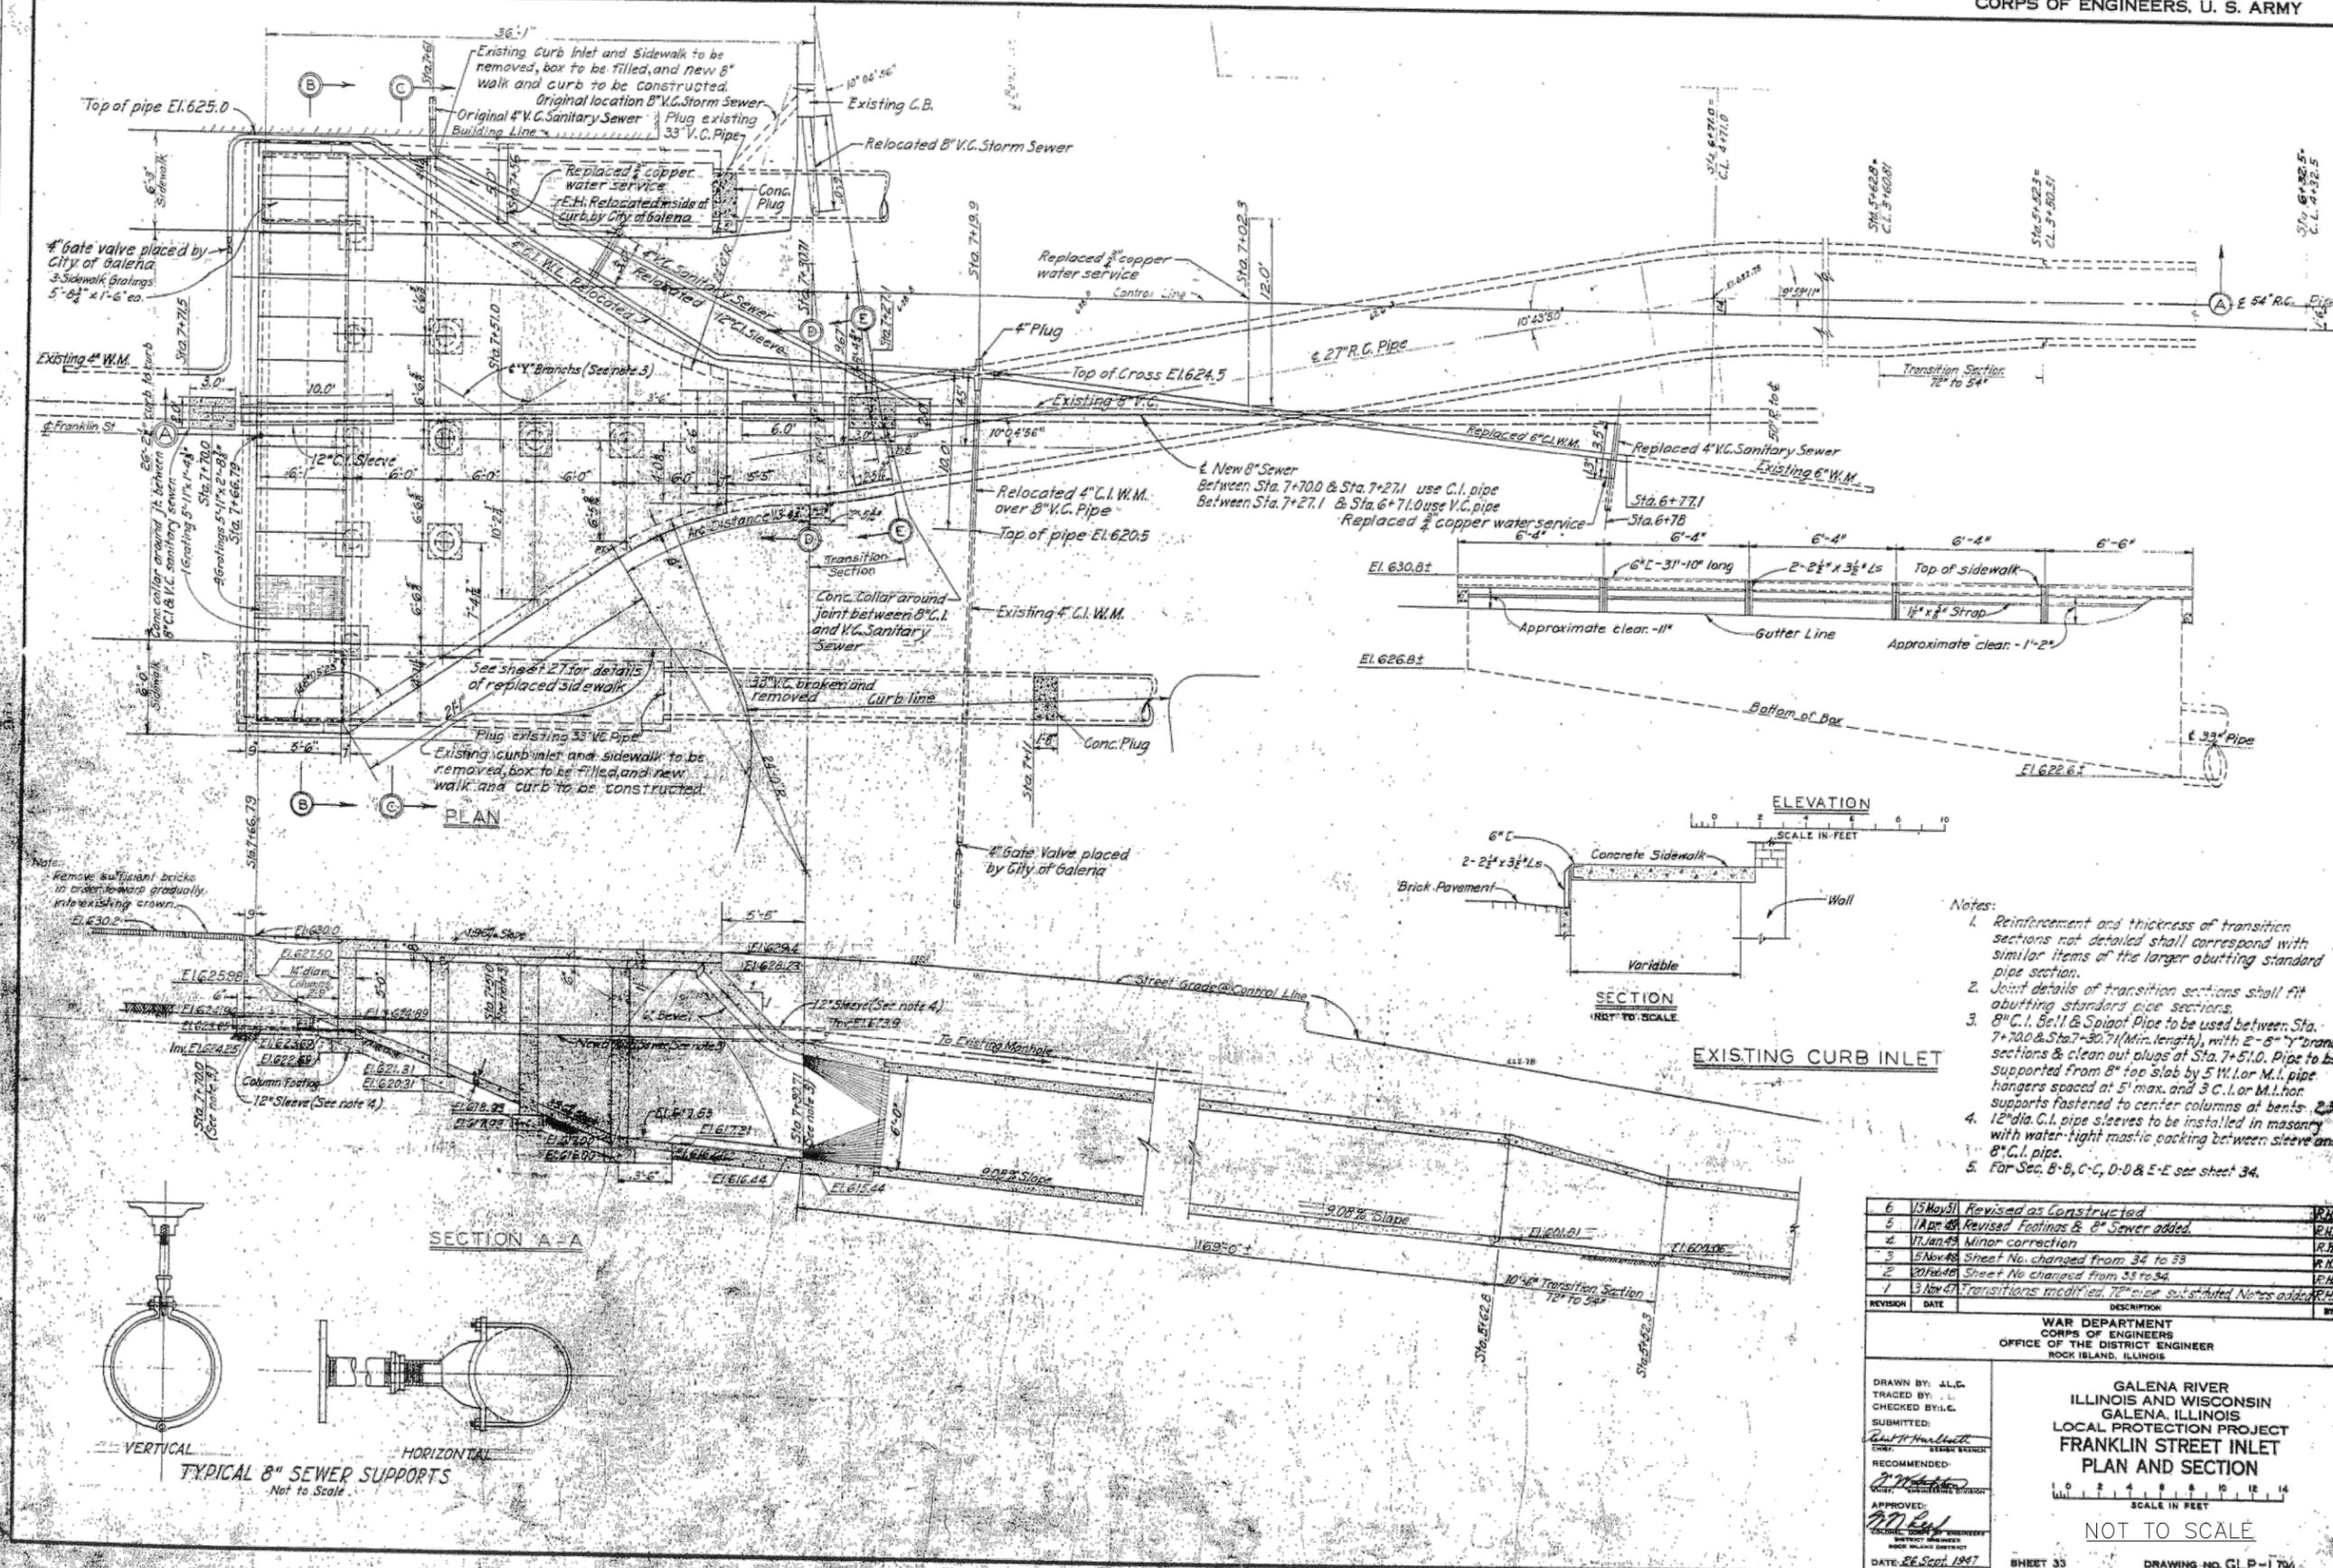

- Notes:
1. Reinforcement and thickness of transition sections not detailed shall correspond with similar items of the larger abutting standard pipe section.
 2. Joint details of transition sections shall fit abutting standard pipe sections.
 3. 8" C.I. Bell & Spigot Pipe to be used between Sta. 7+70.0 & Sta. 7+70.71 (Min. length), with 2-8" x 3" branch sections & clean out plugs at Sta. 7+51.0. Pipe to be supported from 8" top slab by 5 W.L. or M.L. pipe hangers spaced at 5' max. and 3 C.I. or M.L. hangers fastened to center columns at bents. 2-12" dia. C.I. pipe sleeves to be installed in masonry with water-tight mastic packing between sleeve and 8" C.I. pipe.
 4. 12" dia. C.I. pipe sleeves to be installed in masonry with water-tight mastic packing between sleeve and 8" C.I. pipe.
 5. For Sec. B-B, C-C, D-D & E-E see sheet 34.

REVISION	DATE	DESCRIPTION	BY
6	15 May 31	Revised as Constructed	R.H.H.
5	1 Apr 48	Revised Footings & 8" Sewer added.	R.H.H.
4	17 Jan 48	Minor correction	R.H.H.
3	5 Nov 48	Sheet No. changed from 34 to 33	R.H.H.
2	20 Feb 48	Sheet No. changed from 33 to 34	R.H.H.
1	3 Nov 47	Transitions modified, 72" pipe substituted. Notes added.	R.H.H.

WAR DEPARTMENT
 CORPS OF ENGINEERS
 OFFICE OF THE DISTRICT ENGINEER
 ROCK ISLAND, ILLINOIS


GALENA RIVER
 ILLINOIS AND WISCONSIN
 GALENA, ILLINOIS
 LOCAL PROTECTION PROJECT
 FRANKLIN STREET INLET
 PLAN AND SECTION


SCALE IN FEET
 1 2 3 4 5 6 7 8 9 10 11 12 13 14

NOT TO SCALE

BHEET 33 DRAWING NO. GLP-1704

DATE: 22 Sept. 1947

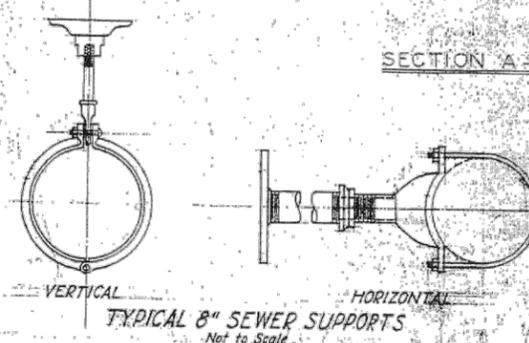

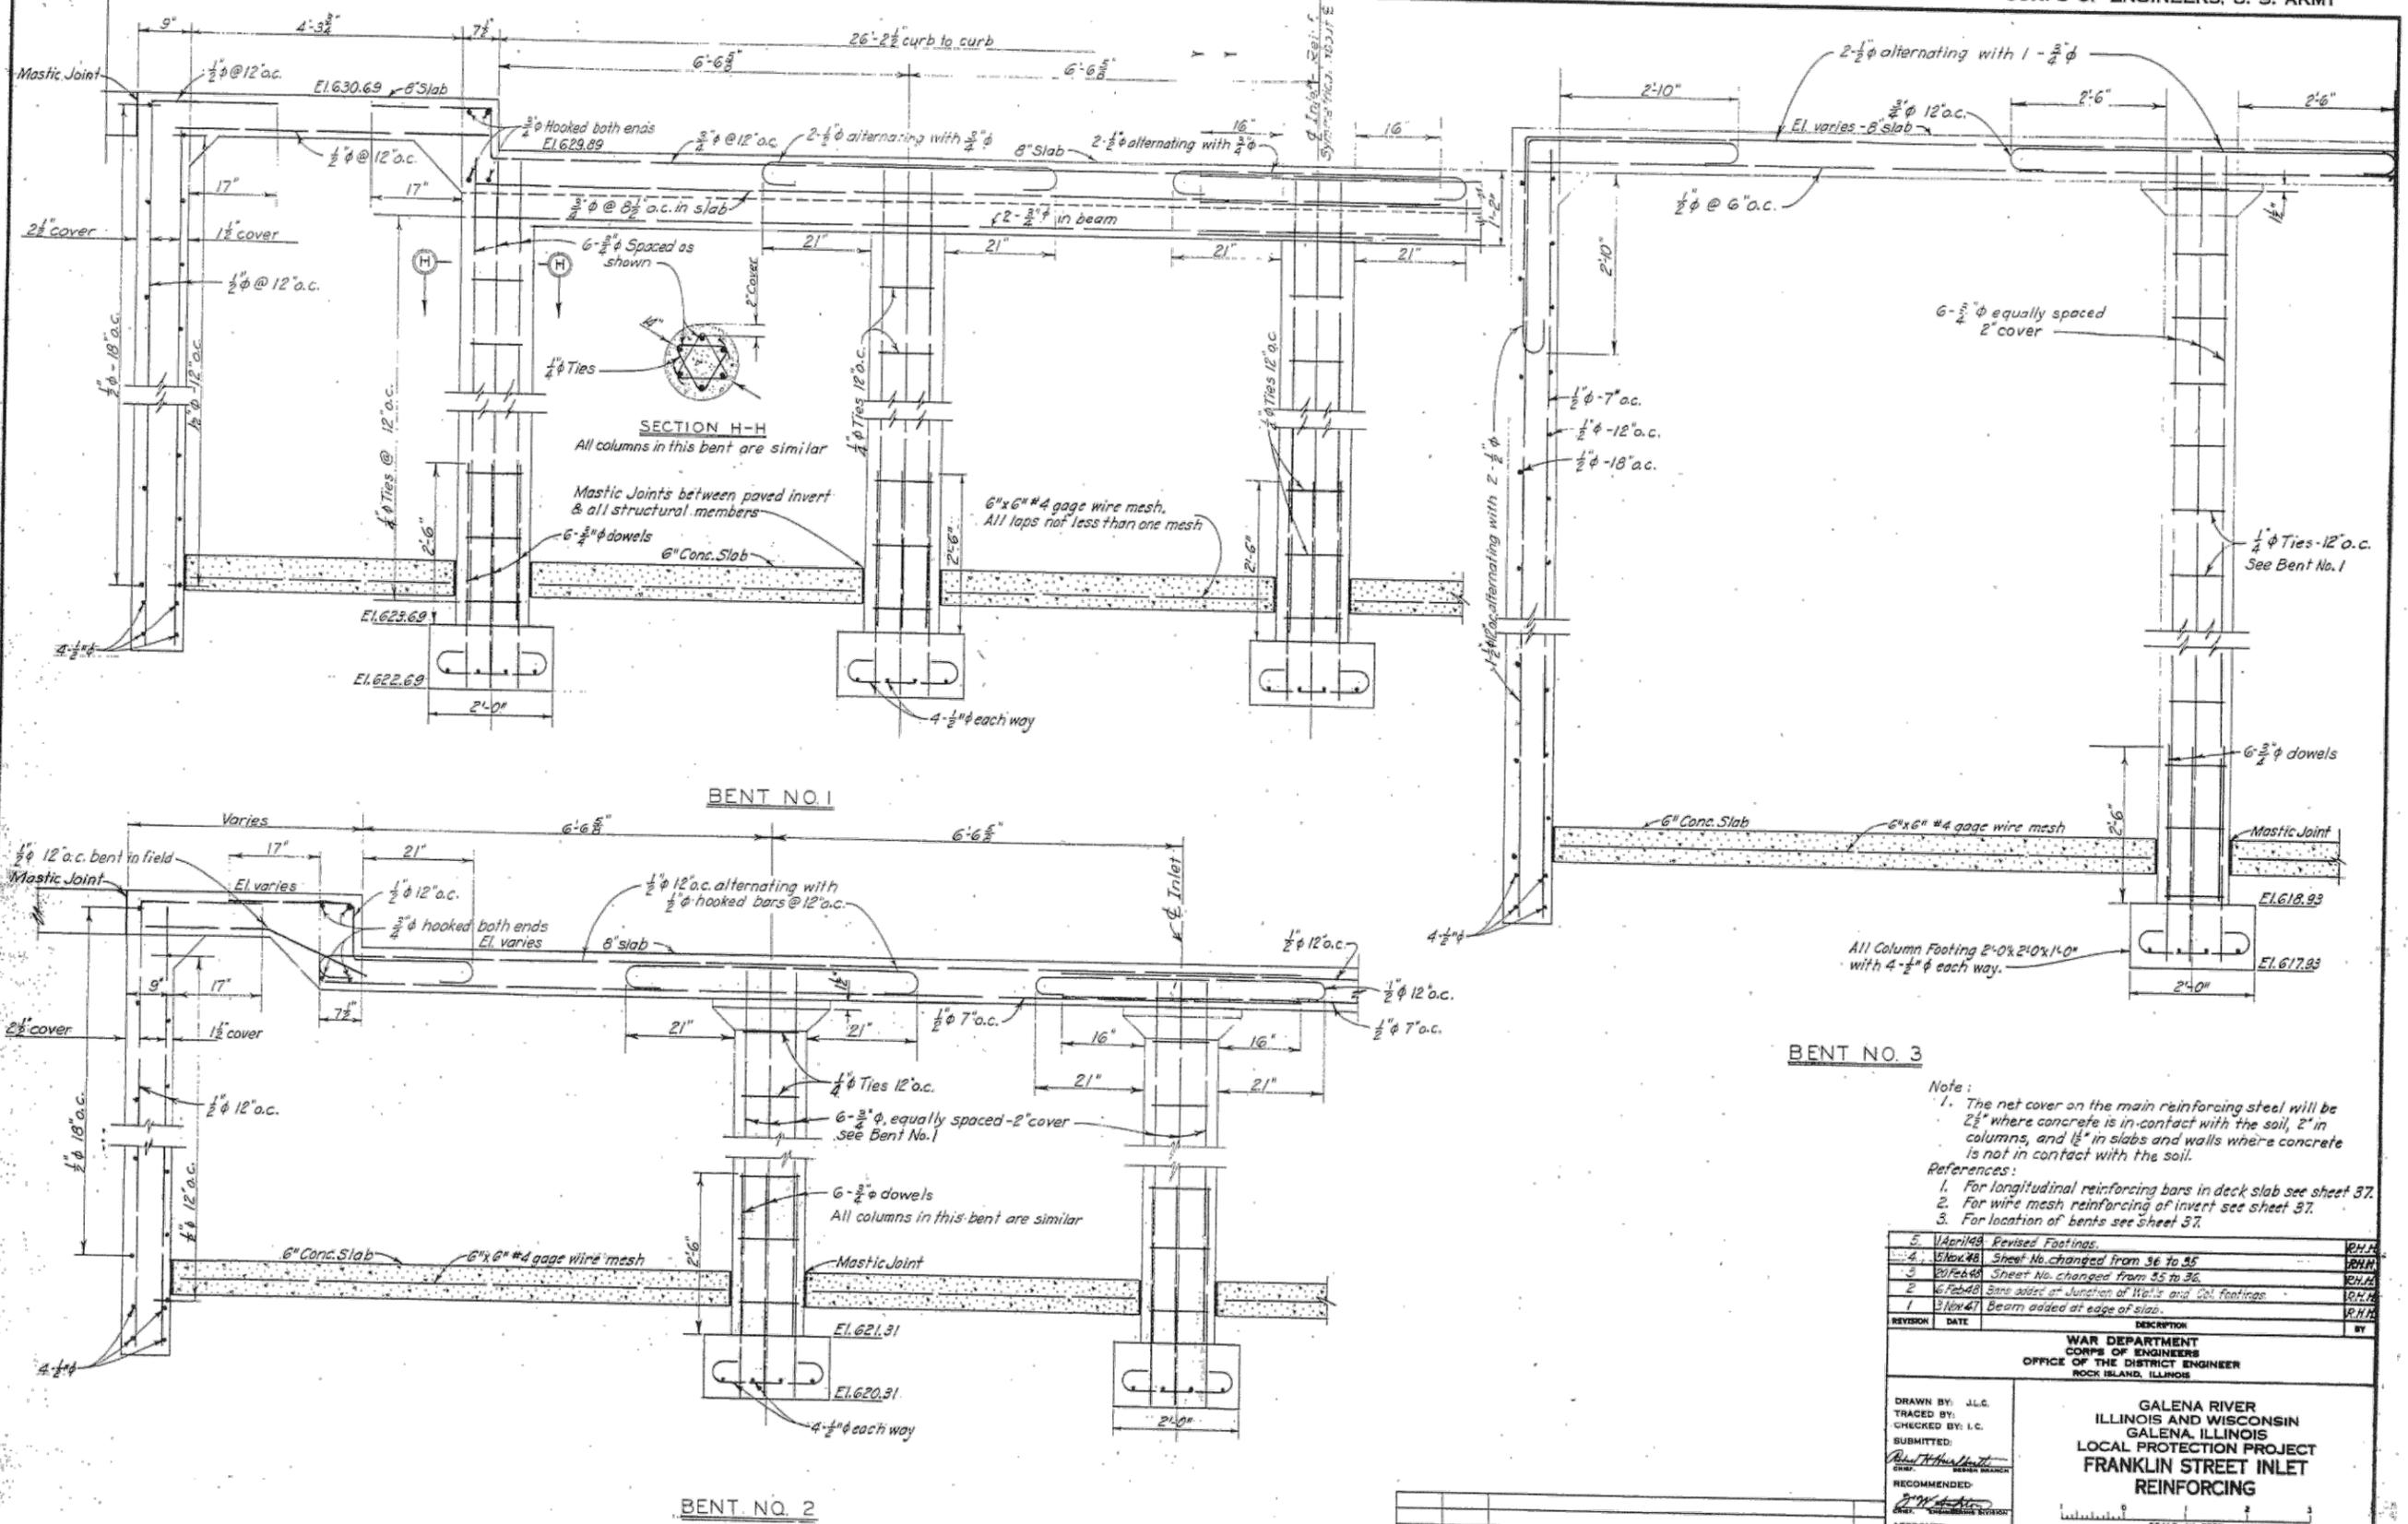

SECTION H-H
All columns in this bent are similar

Mastic Joints between paved invert & all structural members
6" x 6" #4 gage wire mesh. All laps not less than one mesh
6" Conc. Slab
6-3/4" φ dowels

- Note:**
- The net cover on the main reinforcing steel will be 2 1/2" where concrete is in contact with the soil, 2" in columns, and 1 1/2" in slabs and walls where concrete is not in contact with the soil.
- References:**
- For longitudinal reinforcing bars in deck slab see sheet 37.
 - For wire mesh reinforcing of invert see sheet 37.
 - For location of bents see sheet 37.

REVISION	DATE	DESCRIPTION	BY
5	1 April 48	Revised Footings.	R.H.H.
4	5 Nov 48	Sheet No. changed from 36 to 35	R.H.H.
3	20 Feb 48	Sheet No. changed from 35 to 36	R.H.H.
2	16 Feb 48	Bars added at Junction of Wall and Col Footings	R.H.H.
1	3 Nov 47	Beam added at edge of slab.	R.H.H.

WAR DEPARTMENT
CORPS OF ENGINEERS
OFFICE OF THE DISTRICT ENGINEER
ROCK ISLAND, ILLINOIS

DRAWN BY: J.L.C.
TRACED BY: L.C.
CHECKED BY: L.C.
SUBMITTED:
RECOMMENDED:
APPROVED:
COLONEL, CORPS OF ENGINEERS
DISTRICT ENGINEER
ROCK ISLAND DISTRICT

GALENA RIVER
ILLINOIS AND WISCONSIN
GALENA, ILLINOIS
LOCAL PROTECTION PROJECT
FRANKLIN STREET INLET
REINFORCING

SCALE IN FEET

NOT TO SCALE

REVISION	DATE	DESCRIPTION	BY
6	15 Nov 51	As Constructed	R.H.H.

iiw
ARCHITECTURE
CIVIL ENGINEERING
CONSTRUCTION SERVICES
ENVIRONMENTAL ENGINEERING
LAND SURVEYING
MUNICIPAL ENGINEERING
STRUCTURAL ENGINEERING
TRANSPORTATION ENGINEERING
INTEGRITY. EXPERTISE. SOLUTIONS.

© COPYRIGHT 2014
ALL RIGHTS RESERVED.
THESE DOCUMENTS HAVE BEEN
PREPARED SPECIFICALLY FOR THIS
PROJECT ONLY. NO PART OF THIS
DOCUMENT MAY BE REPRODUCED
OR DISTRIBUTED IN ANY FORM
WITHOUT THE PERMISSION OF IIW,
P.C. ALL INFORMATION IN THIS
DOCUMENT IS CONSIDERED
PROPERTY OF IIW, P.C.

EXISTING PLAN SHEET

FRANKLIN STREET
DRAINAGE STRUCTURE TEMPORARY SHORING
GALENA, ILLINOIS

P. 16178 DRAWINGS STRUCTURAL 16178 E. EXISTING PLANS DWG. 9/7/2016 1:04 PM DAVE SCHWARZ

Project Description	Drawn By	Issued For Construction	Date	By

Sheet No: **E1.2**

Project No: 16178

